
From: spill12 <spill12@tceq.texas.gov>
Sent: Friday, April 5, 2019 1:46 PM
To: Mike Gaudet; bweber@iterm.com; dwascome@iterm.com; mtaylor@iterm.com
Cc: Kelly Cook; Martin, John; Adams, Adam; Nicole Bealle
Subject: Stormwater Discharge response information
Attachments: 20190404153721570.pdf


Mike,

The TCEQ is requesting that this information be provided promptly. Please respond with a confirmation of this email.

In addition to the information requested on 4/3, please provide the following information:

1. Regarding non-fire impacted stormwater management:
 - Provide a volume of accumulated non-fire impacted stormwater.
 - Prior to discharging stormwater, ITC is to conduct pre-sampling of the water to be discharged from the non-fire impacted area(s). ITC must demonstrate that no contaminants related to the fire or firefighting activities will impact the discharge and that only discharges allowed by the facility's TPDES permit will be discharged from this outfall. Provide pre-discharge sample results to the TCEQ via the command structure. TCEQ received analysis results of samples for stormwater that we understand is intended to be released through outfall 005 with a COD of approximately 20 mg/L. This meets COD limits and may be released after meeting the other requirements listed here (provide volume and coordinate the discharge).
 - Coordinate any stormwater discharge with the surface water recovery group prior to discharge.
2. Regarding the request of 4/4/19 to have a temporary alternate discharge location (attached) for non-impacted stormwater:
 - Provide pre-discharge non-fire impacted area stormwater sample results for the standard stormwater parameters.
 - Prior to discharge, coordinate with the surface water recovery group.
 - The TCEQ has no objections with a temporary re-routing of this stormwater away from outfall 003 and allowing the discharge as proposed.

★ Allow to pump stormwater directly to Tidal Road ditch instead of via 003.

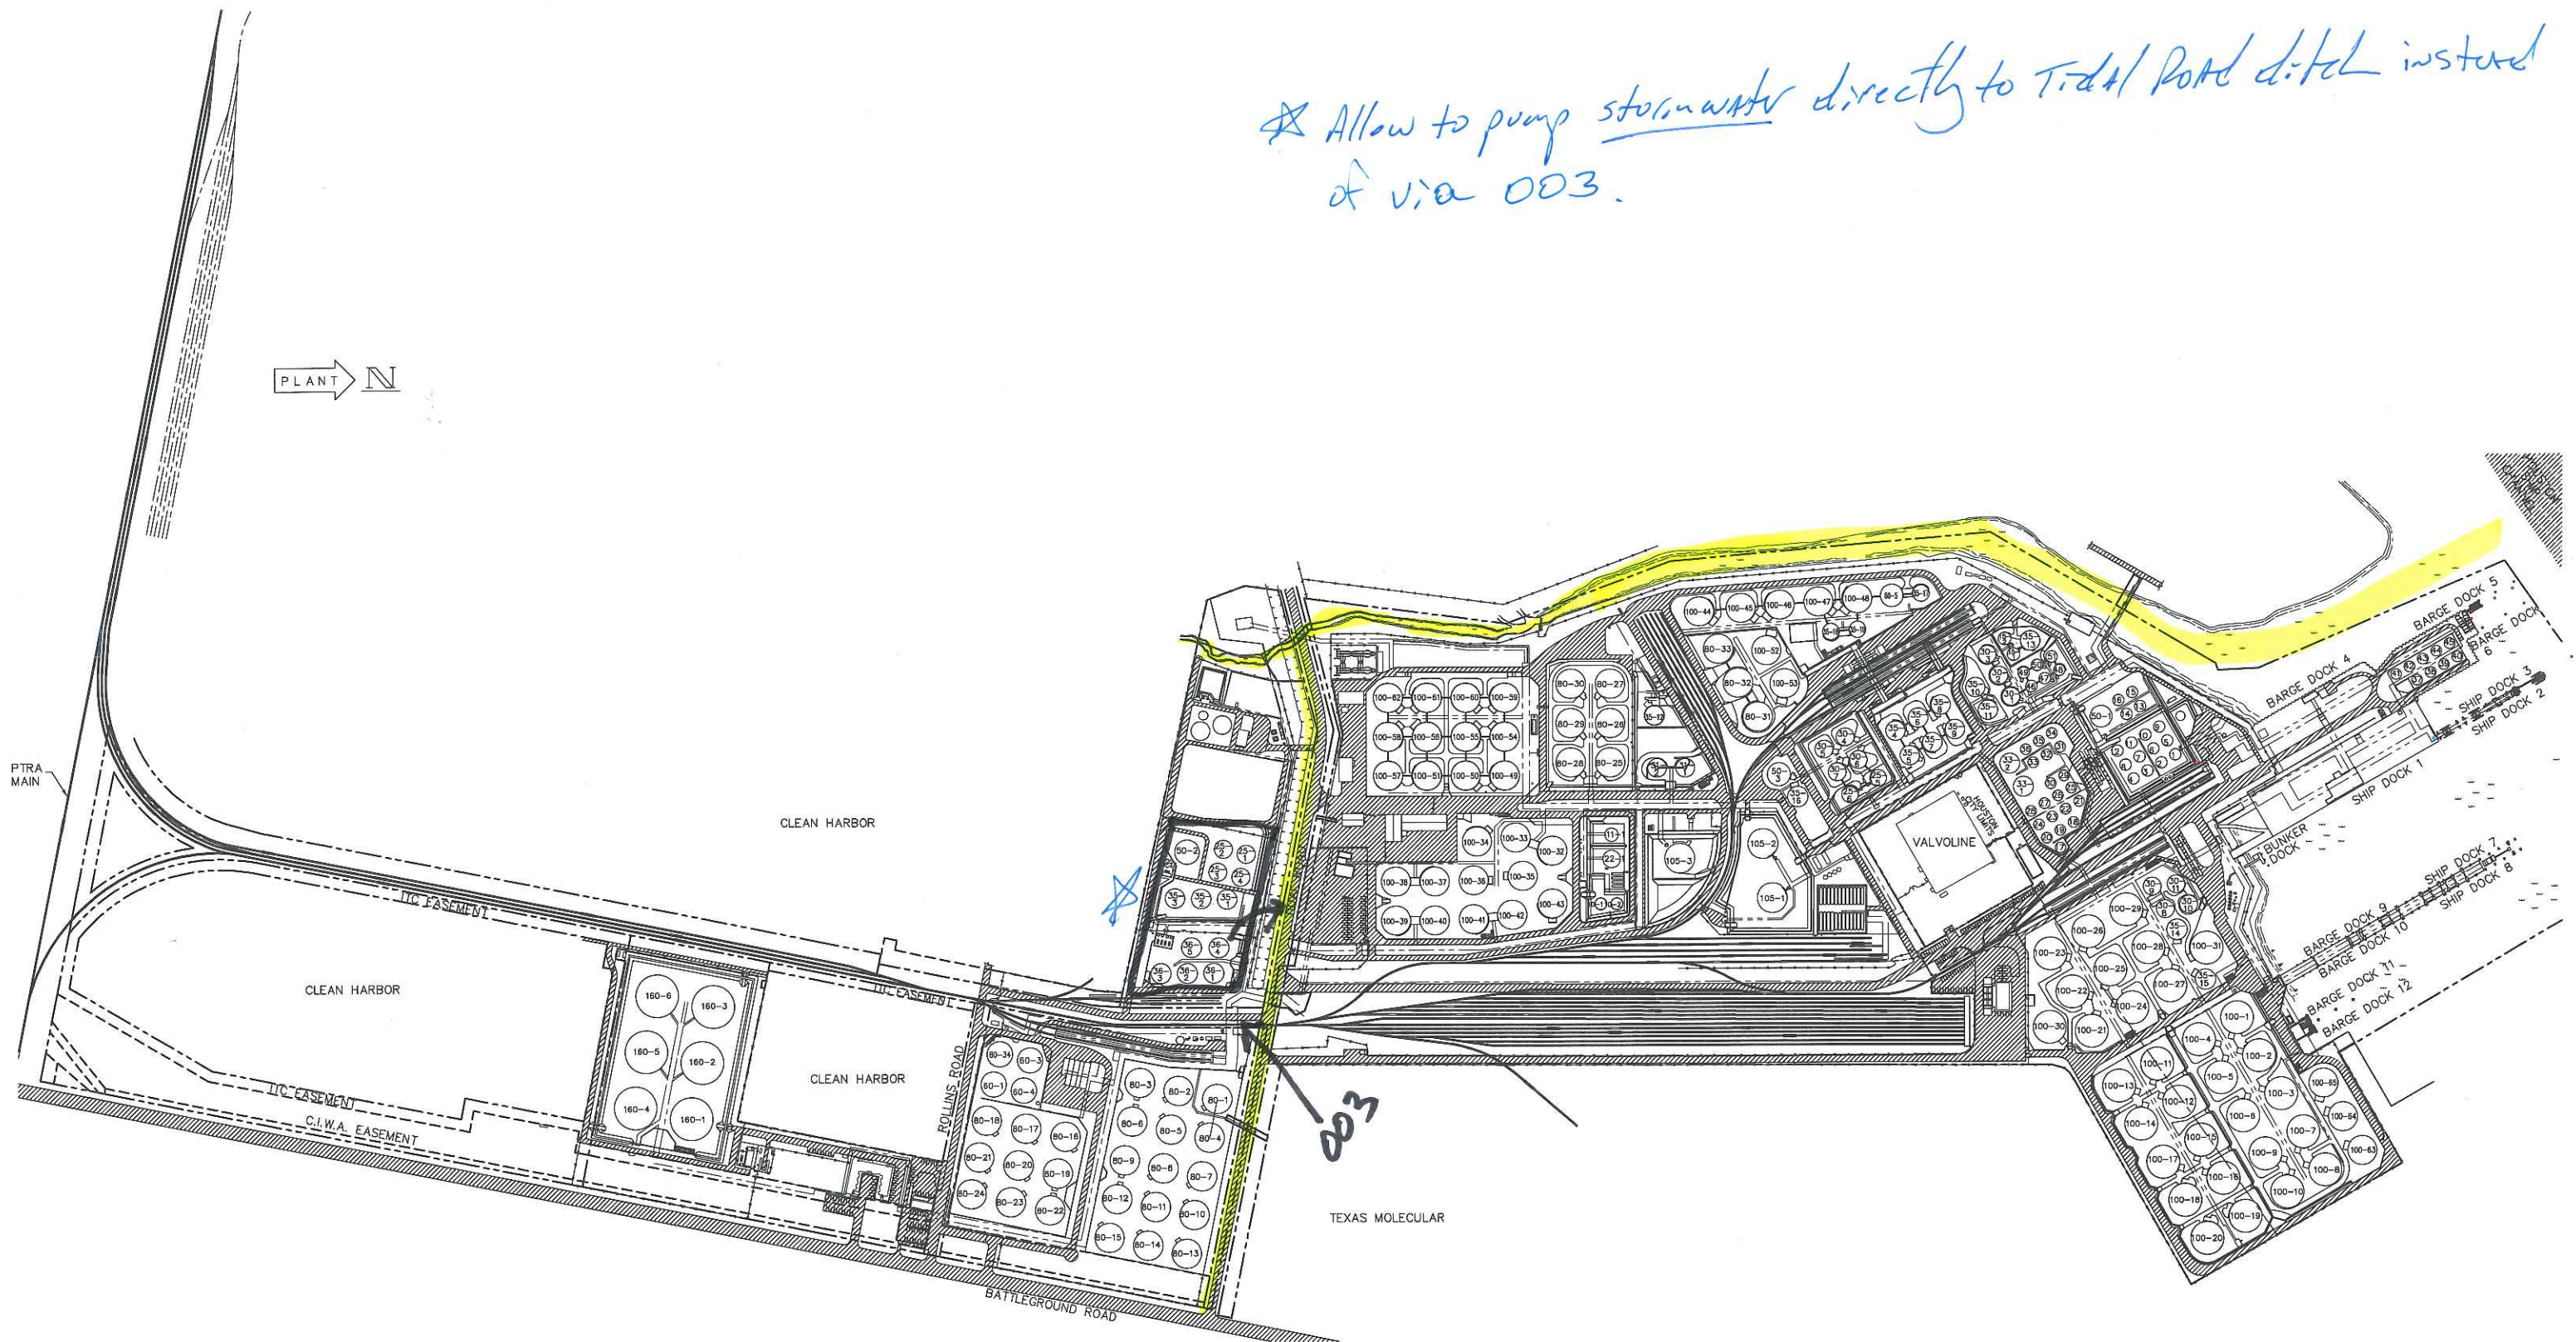

NOTE:
ALL DIMENSIONS TO BE FIELD VERIFIED
BY CONTRACTOR BEFORE CONSTRUCTION.

A	RJL	5/17	GENERAL REVISION UPDATE
REV.	BY	DATE	DESCRIPTION

Intercontinental
Terminals
Company

P.O. Box 698 Deer Park, Tx. 77536

DATE: 1/15/10	22x34 SCALE: 1=300	11x17 SCALE: 1=600	DRAWN BY RJL
REVISED 5/12/17			

PLOT PLANS

OVERALL PLOT PLAN

DRAWING NUMBER
XXX

C.N. 8940